


CONFIDENTIAL

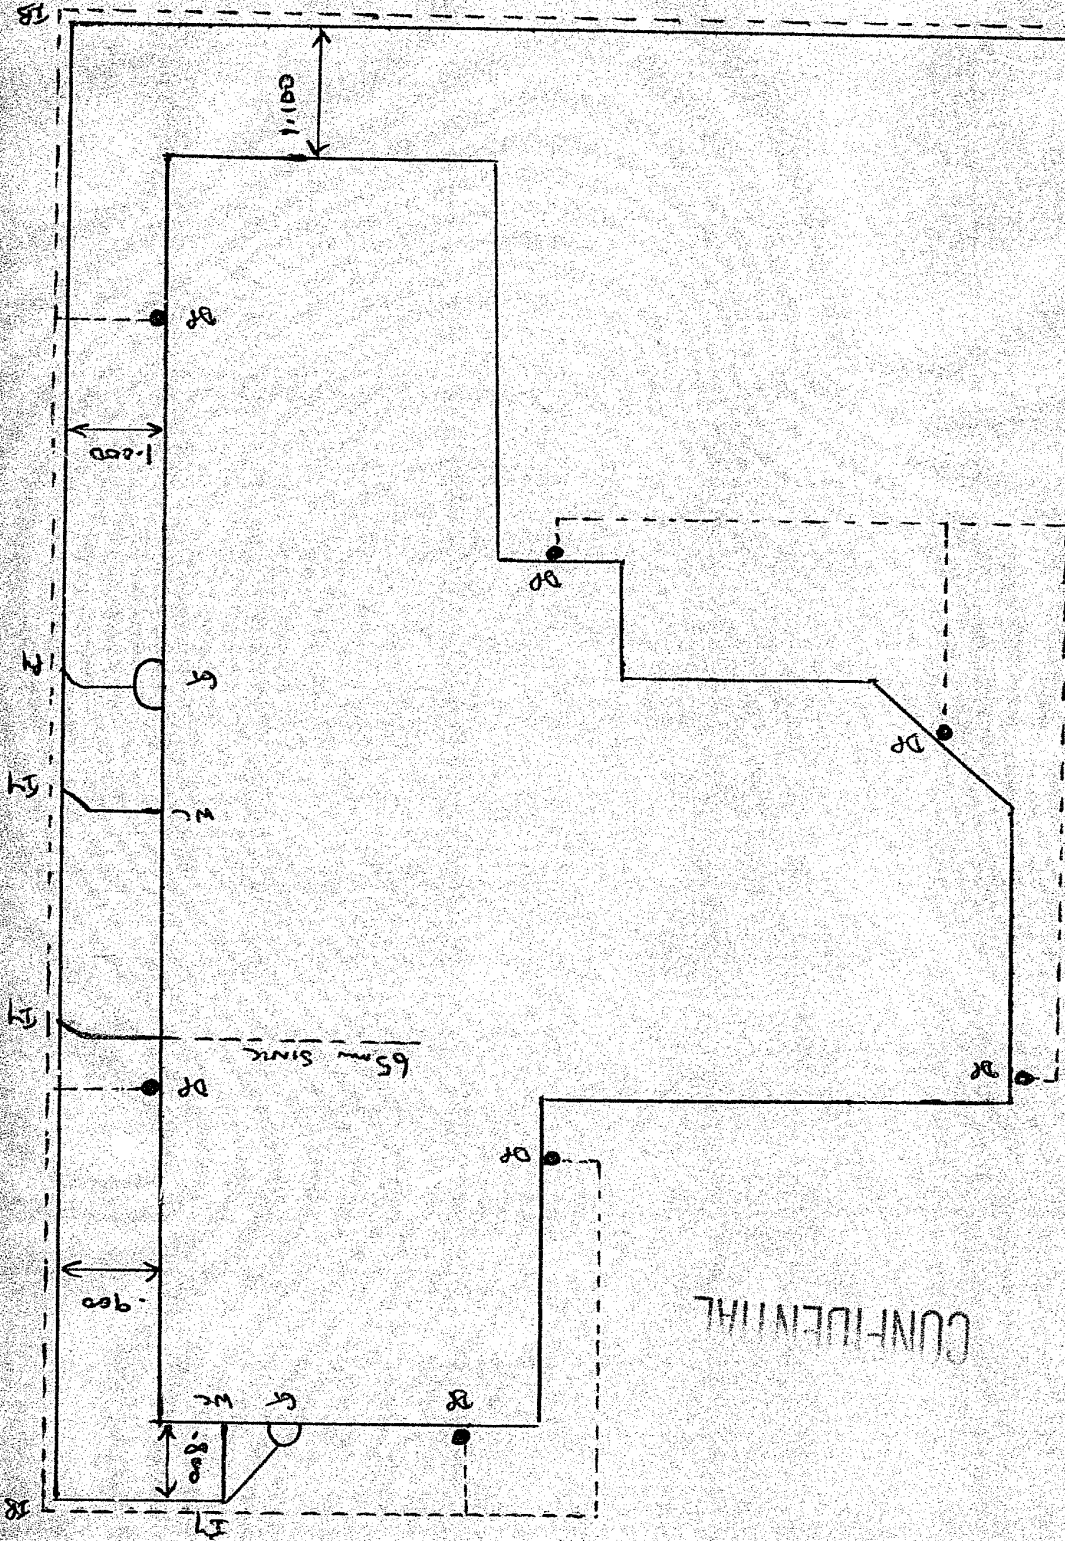

M. NEWBOK
 4850
 16-4-98

94/2906.

TODD DAVIES - BUILDER
 SYKES FERRISSE
 LOT 89
 MANGAKOHA RURAL
 HAMMERSLEY

CONFIDENTIAL

4/5 meters
 8/10 P