

HAMILTON CITY COUNCIL

As Laid Drainage Plan

Owner: *D. Mac Mahon*

Lot: *3* DP/S *70 745*


Street: *95 Dixon Rd*

Drainlayer: *B. Denton* No *07005*

Consent No: *1*

Date of Inspection: *23-10-96*

Inspector: *[Signature]*

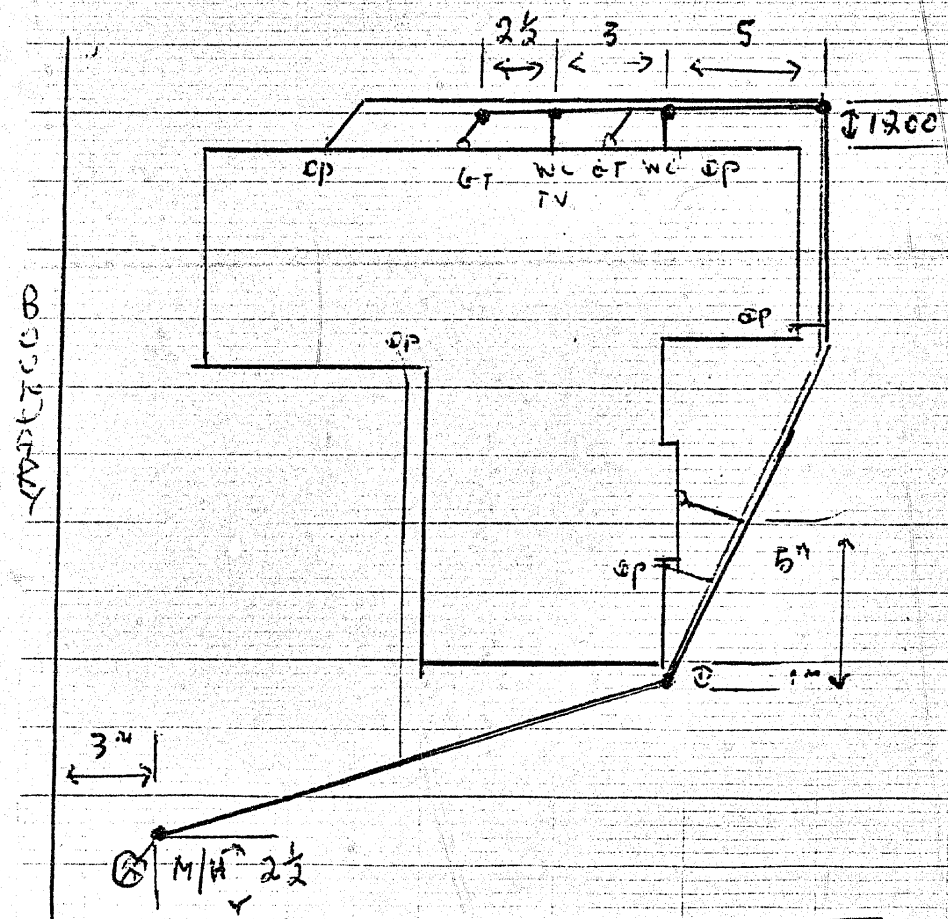

BARRY DENTON

07005

24-10-96

SCALE 1=200

S/W TO K+C DIXON ROAD

MACMAHON

95 DIXON RD