

STREET: DIXON ROAD No: 95

LOT: DPS

OWNER: _____

DRAINLAYER: DRAINAGE SYSTEMS


INSPECTOR: T. SHARP.

REG No: 17944

DATE OF INSPECTION: 16/4/10

CONSENT No: _____

DRAINLAYER PLEASE FILL IN ALL DETAILS

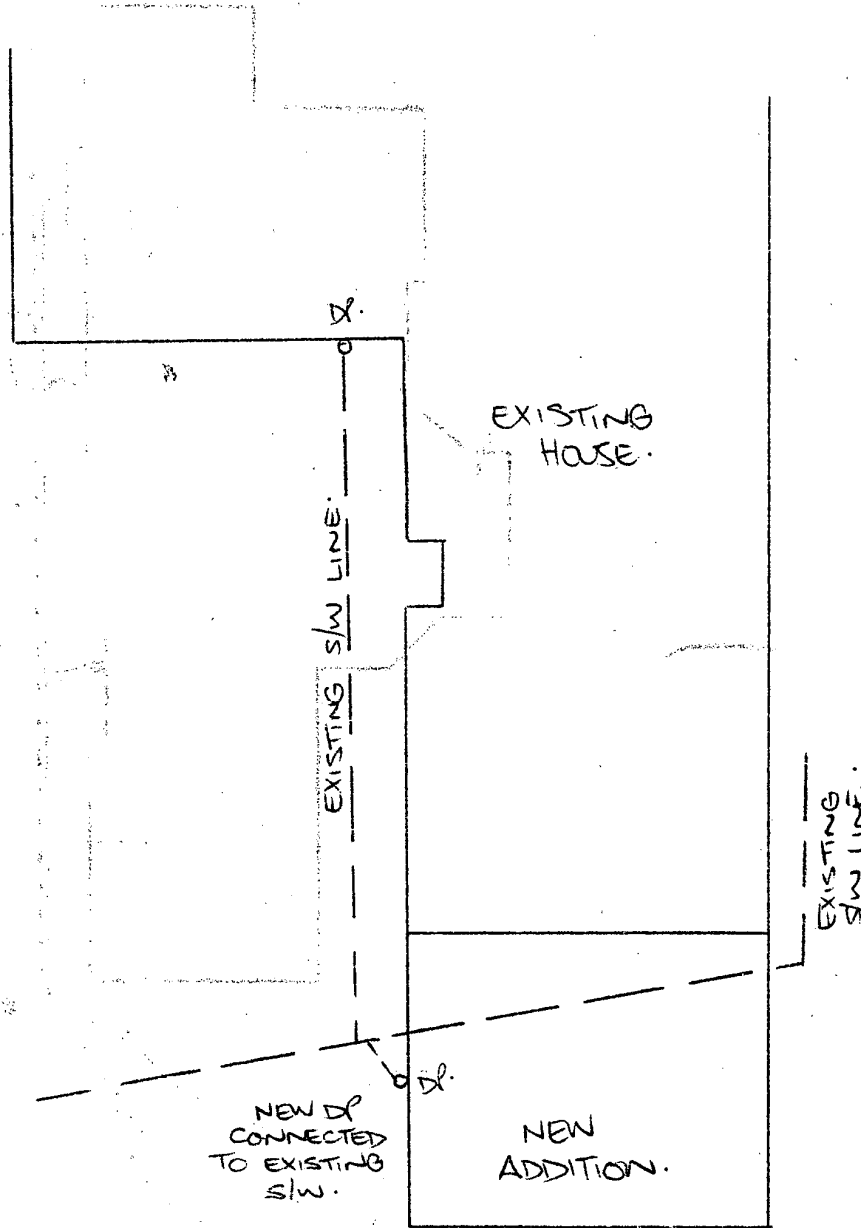

DRAINLAYER'S SIGNATURE: [Signature]

DATE: 15/04/10