

Private Bag 3010, Hamilton, New Zealand.

FAX: (07) 838 6950

BUILDING UNIT

AS LAID DRAINAGE PLAN

STREET: Mahoe St **No:** 147

LOT: 28 DPS 9257

OWNER: Dennis Frelander

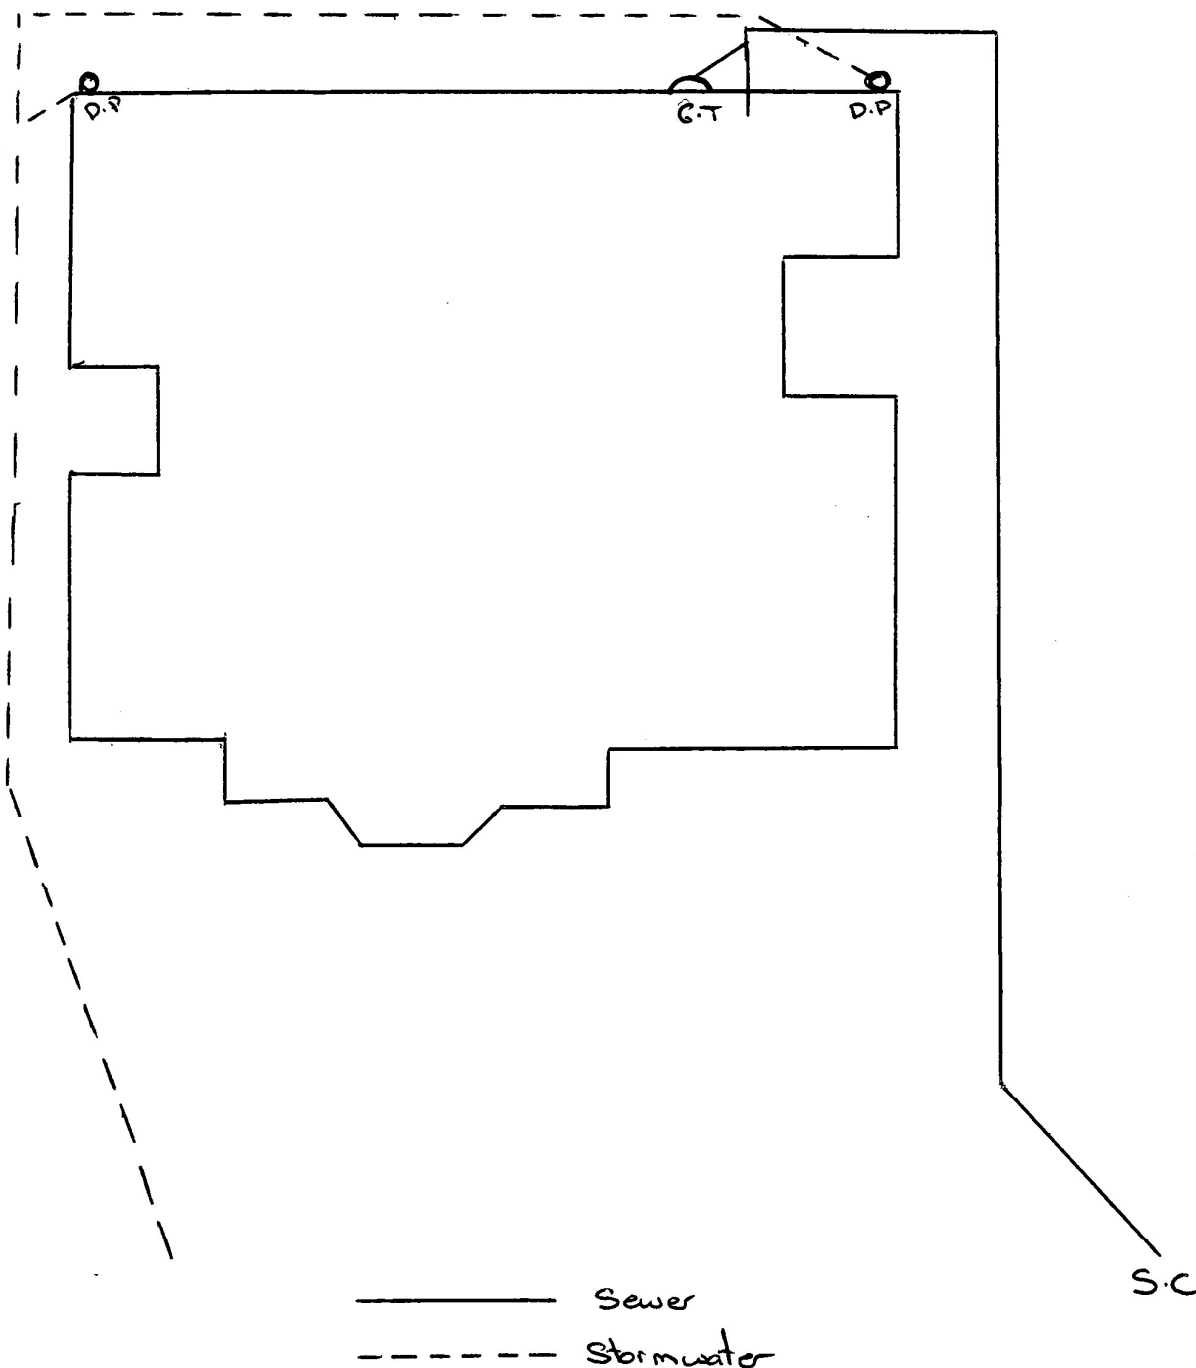
DRAINLAYER: Anthony Bell

INSPECTOR: _____

REG No: 23153 ✓

DATE OF INSPECTION: _____

CONSENT No: _____

DRAINLAYER PLEASE FILL IN ALL DETAILS

Mahoe St

DRAINLAYER'S SIGNATURE: Anthony Bell **DATE:** 10-06-11

DATE: 10-06-11

ALDP version 1 04/2002