


37373

P1

See

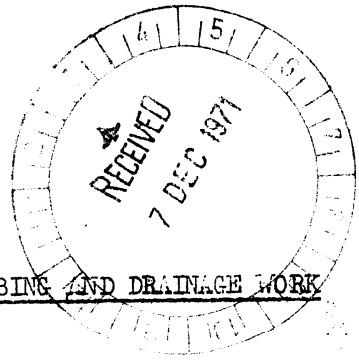

CITY OF HAMILTON

APPLICATION FOR PERMIT FOR SANITARY, PLUMBING AND DRAINAGE WORK

To the HAMILTON CITY COUNCIL:-

I, the undersigned (name in full)..... C.F. REESE LTD.
of (address)..... 52 KING ST.

hereby made application for permission to carry out the work prescribed herein, and as set out in the plans attached hereto, at the premises situated in 14 MAEROA Rd. Street/Road being Lot..... 2
of Section..... D.P.S. 13791

Name and address of owner of premises..... MR. M.B. JENKINS
..... 14 MAEROA Rd.

Nature of Work..... C.W.T. IN FOR FUTURE EXTENSION


Value of proposed work including materials \$ 0
(a) Plumbing
(b) Drainage (including stormwater) \$ 90.00
\$ 90.00

..... Regd. No. Licensed Plumber
..... Regd. No. 11166 Licensed Drainlayer
Dated this 7th day of December 1976..

\$1 GR 8526
~~70 pay~~

14 Maercoo Rd
lot 2
DPS 13791
PERMIT NUMBER
DPS 13791

existing drain

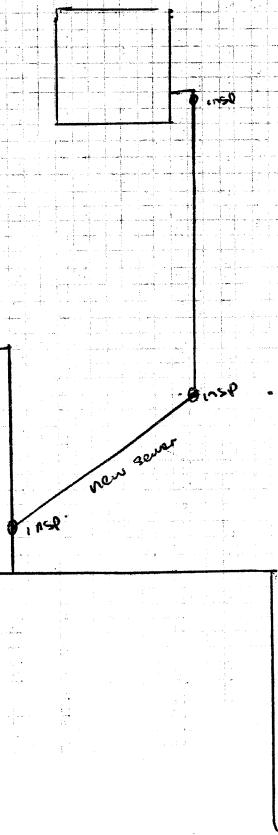

PROBOX