


**As Laid Drainage**

Building Consent Number: **2016/33796** Date: **17/6/16** No. of pages: **2/2**
Address: **33 Boundary Rd Hamilton**
Drain Layer Name: **Brent Tupaea** (Please print clearly) Signature: *[Signature]*
Registration Number: **14000** Business Name: **Laser Plumbing Hamilton East**
To Council: (Tick) ☐ Hauraki ☐ Matamata Piako ☐ Waitomo ☐ Otorohanga ☐ Waipa ☐ Waikato ☒ Hamilton



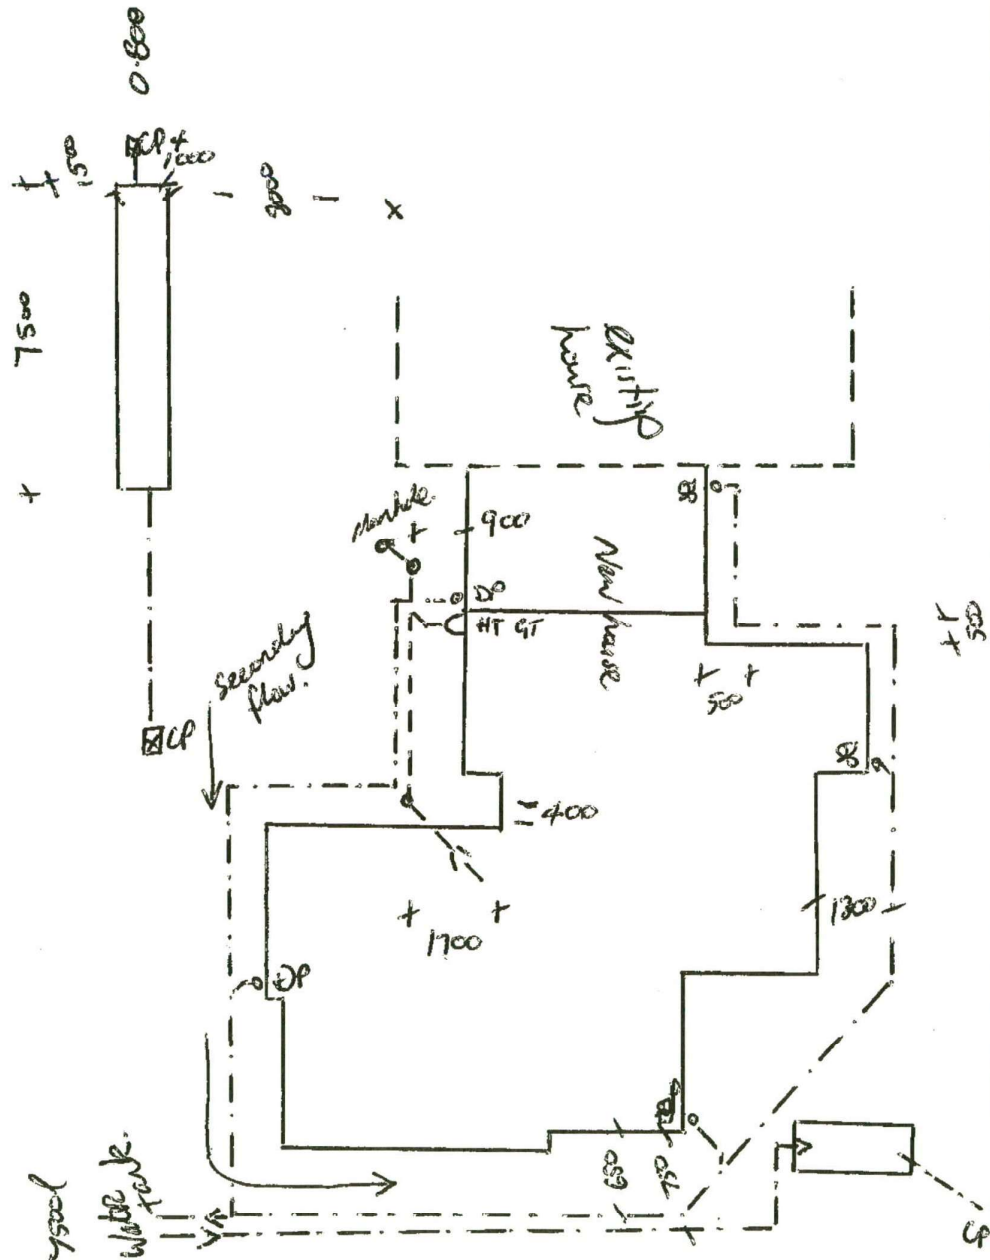

As Laid Drainage

Building Consent Number: *2016/33796* Date: *17/6/16* No. of pages: *1/2*
Address: *33 Bandy Rd, Hamilton*
Drain Layer Name: *Brent Tupaea* [Please print clearly] Signature: *[Signature]*
Registration Number: *14000* Business Name: *Laser Plumbing Hamilton East*
To Council: [Tick] ☐ Hauraki ☐ Matamata Piako ☐ Waitomo ☐ Otorohanga ☐ Waipa ☐ Waikato ☒ Hamilton

