



As Laid Drainage

Building Consent Number:

Date: 06 10 7 120 No. of pages:

Building Address: 69 NORRIS ST

Drain Layer Name: A. SHEPHERD


Registration Number: CD 21608

[Please print clearly] Signature: *[Signature]*

Business Name: TITAN DRAINAGE

To Council: [Tick]

- Hamilton
- Hauraki
- Matamata-Piako
- Otorohanga
- Thames-Coromandel
- Waipa
- Waikato
- Waitomo

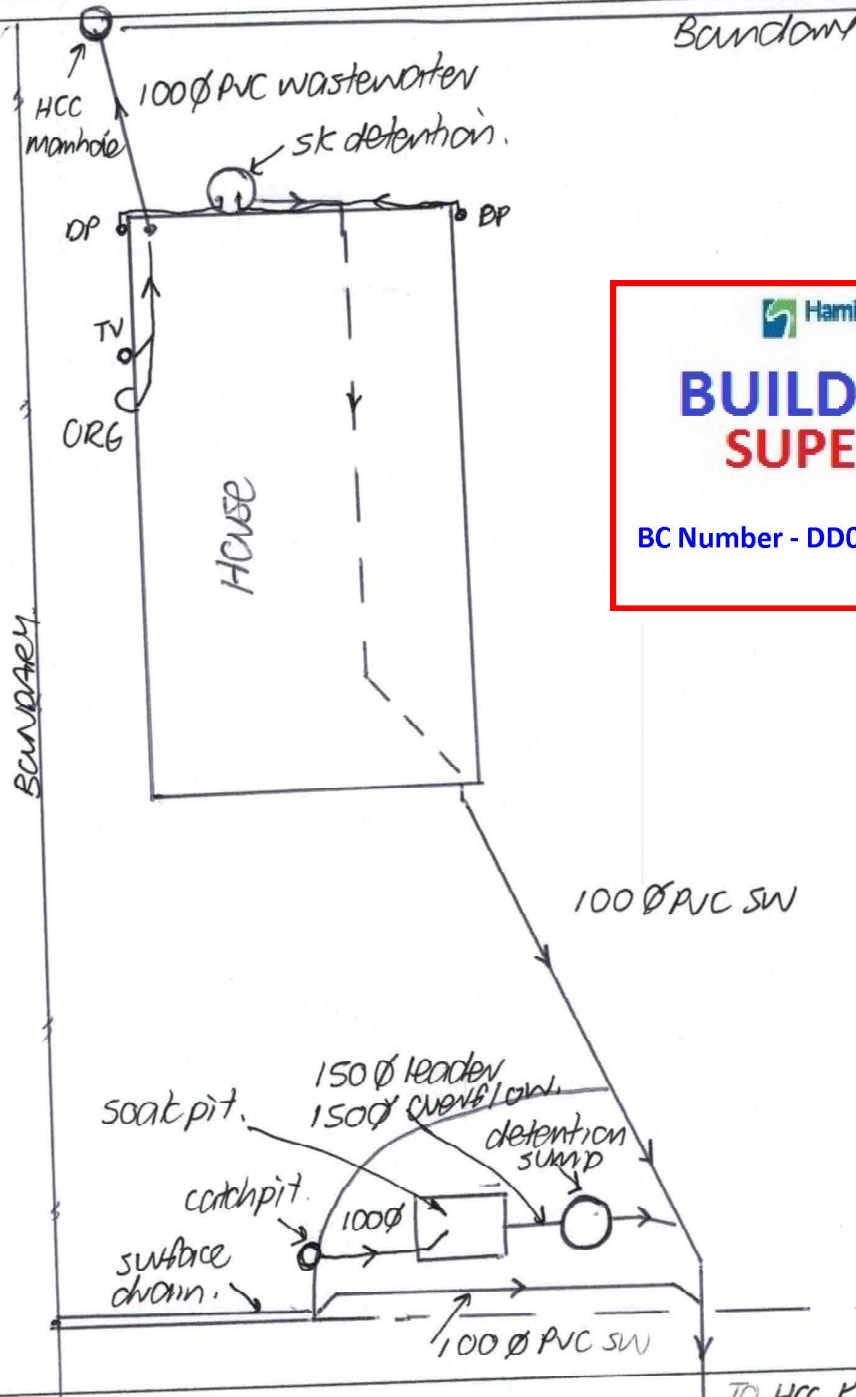


BUILDING UNIT
SUPERSEDED
 BC Number - DD007.2019.00039869.001

