

OFFICE OF THE CHIEFBUILDING SUPERVISOR
PRIVATE BAG, HAMILTON, N.Z.
PHONE 386-399

HAMILTON CITY



APPLICATION FOR PERMIT FOR SANITARY, PLUMBING AND DRAINAGE WORK
SEE BEE DRAINAGE LTD.

P.O. BOX 5449,
FRANKTON.

I, the undersigned (name in full) address

Hereby make application for permission to carry out the work prescribed herein, as set out in the plans attached hereto, at the premises situated in:-

67 CAMP BERT Street/being Lot 53 D.P.S. 15520

Name and Address of owner of premises: Mr. Dalsell

Nature of Work New Drivelling

Value of proposed work excluding materials \$

(a) Plumbing

(b) Drainage (including stormwater)

..... Regd No. Licensed Plumber

3885 Regd. No. Licensed Drainlayer

Dated this 31/1/87 day of January 1987


Building Permit 37969 Drainage Permit 028627 Plumbing Permit

Plumbing & Drainage Costs Plumbing & Drainage Fees


Details of drainage and boundaries required overleaf.

N.B. Sewer ONLY 30/10/87.

AS LAID

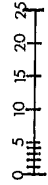

STREET 67 Campbell Street

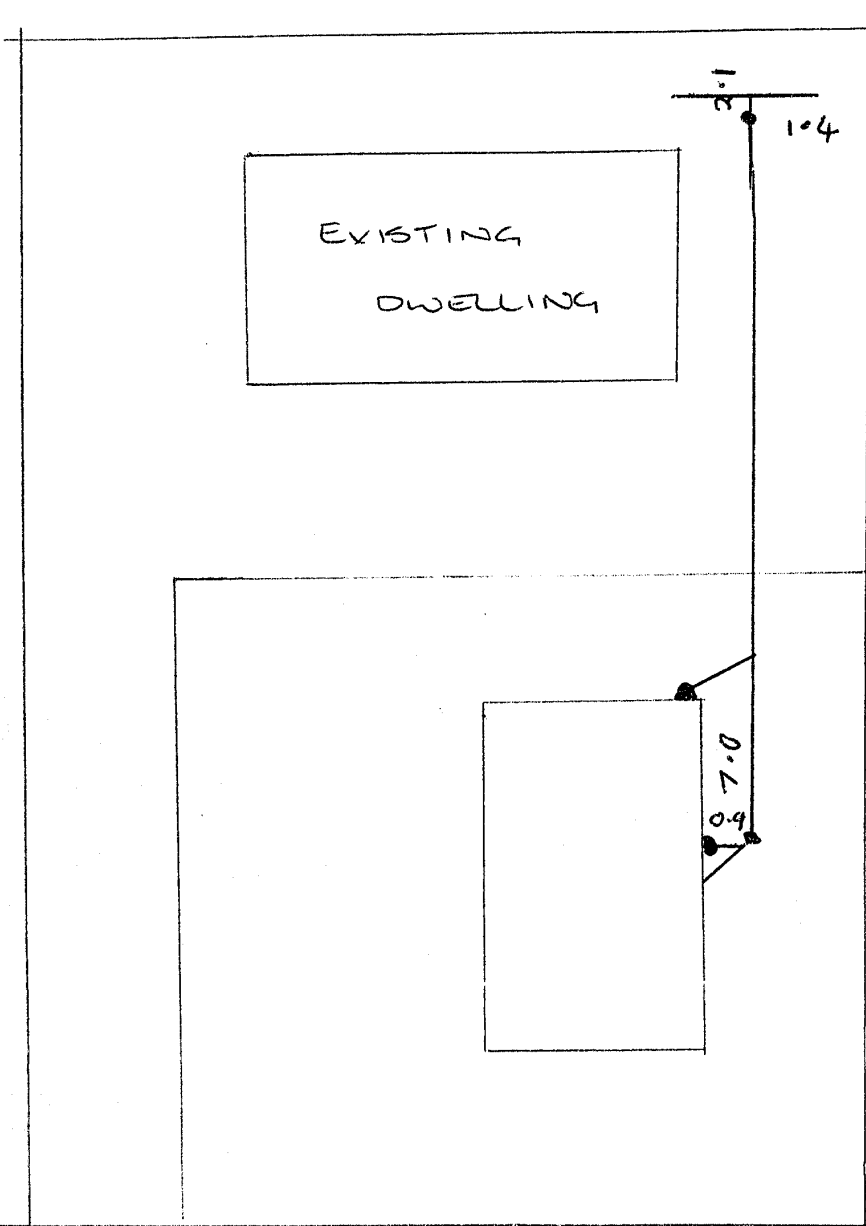

Campbell Street

Handwritten signature

Date of Inspection 30-10-87

Drainlayer's Signature