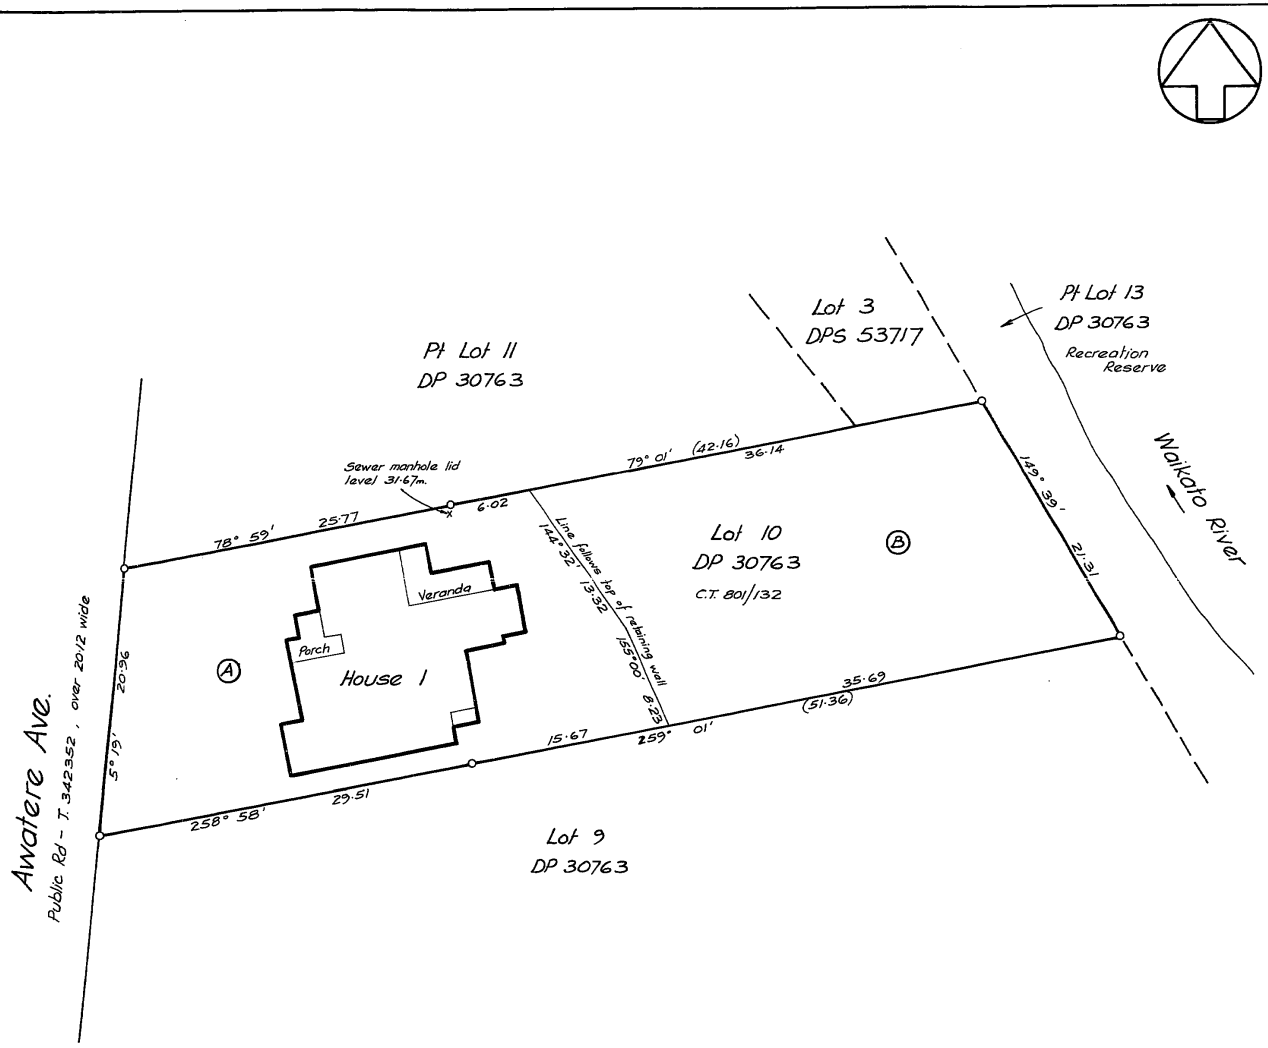

Approvals

Pursuant to Sec. 314 Local Government Act 1974 I hereby certify that the building depicted hereon was constructed before 1st April 1979 and was provided with such safeguards against fire, and means of escape in case of fire, as were required by the by-laws of the Hamilton City Council applying as at the date of this certificate.

Dated this 16th day of FEBRUARY 1990

City Secretary / Associate Town Clerk

I hereby certify that the building shown hereon is erected in the position shown and is within the boundaries of Lot 10 DP 30763, C.T. 801/132.

Registered Surveyor 5.2.90

Height Restriction

Height restriction over area B hereon being 31.70 metres a.s.l. in terms of Moturiki Datum.

Level origin SS 215, lev. 33.53m, Moturiki Level Datum

Approved by owners :

W. B. Jolly M. A. Jolly

Total Area 1497m²

Comprised in All CT 801/132

I, John Jeffery Carter

Registered Surveyor and holder of an annual practising certificate (or who may act as a registered surveyor pursuant to section 25 of the Survey Act 1986) hereby certify that this plan has been made from surveys executed by me or under my directions, that both plan and survey are correct and have been made in accordance with the Survey Regulations 1972 or any regulations made in substitution thereof.

Dated at Hamilton this 5th day of Feb. 1990 Signature

Field Book p. Traverse Book p.

Reference Plans DP 30763, DPS 53717

Examined Correct

Approved for leasing purposes only

9/3/90 L.T. Surveyor

Deposited this 13th day of March 1990

Assistant District Land Registrar

File

Received 27-2-90

Instructions

DPS 55598

LAND DISTRICT South Auckland	House on Lot 10 DP 30763	**TERRITORIAL AUTHORITY** Hamilton City
SURVEY BLK. & DIST. XIII Komakorau		**Surveyed by** Carter Keucke & Latham 89586
NZMS 261 SHT S 14 **RECORD MAP No** 40-29		**Scale** 1:250 **Date** February 1990

RE-ORDER ACE N93/86

DIRECTOR GENERAL, SURVEY & LAND INFORMATION

L & S FORM N93

MICROBOX MICROFILM RECORDS (WAIKATO) LTD HAMILTON